

PLOTTED BY: Pamela Sellers DATE: 29/10/2020

DRAWING FILE LOCATION: \\VNTWAJDKFP01\Group\Design\ECW Projects\ECW19182-3 - As Cons - Traffic Controller Replacement Program -19-20 Part 2\02 Drawings\LM00389A.dwg

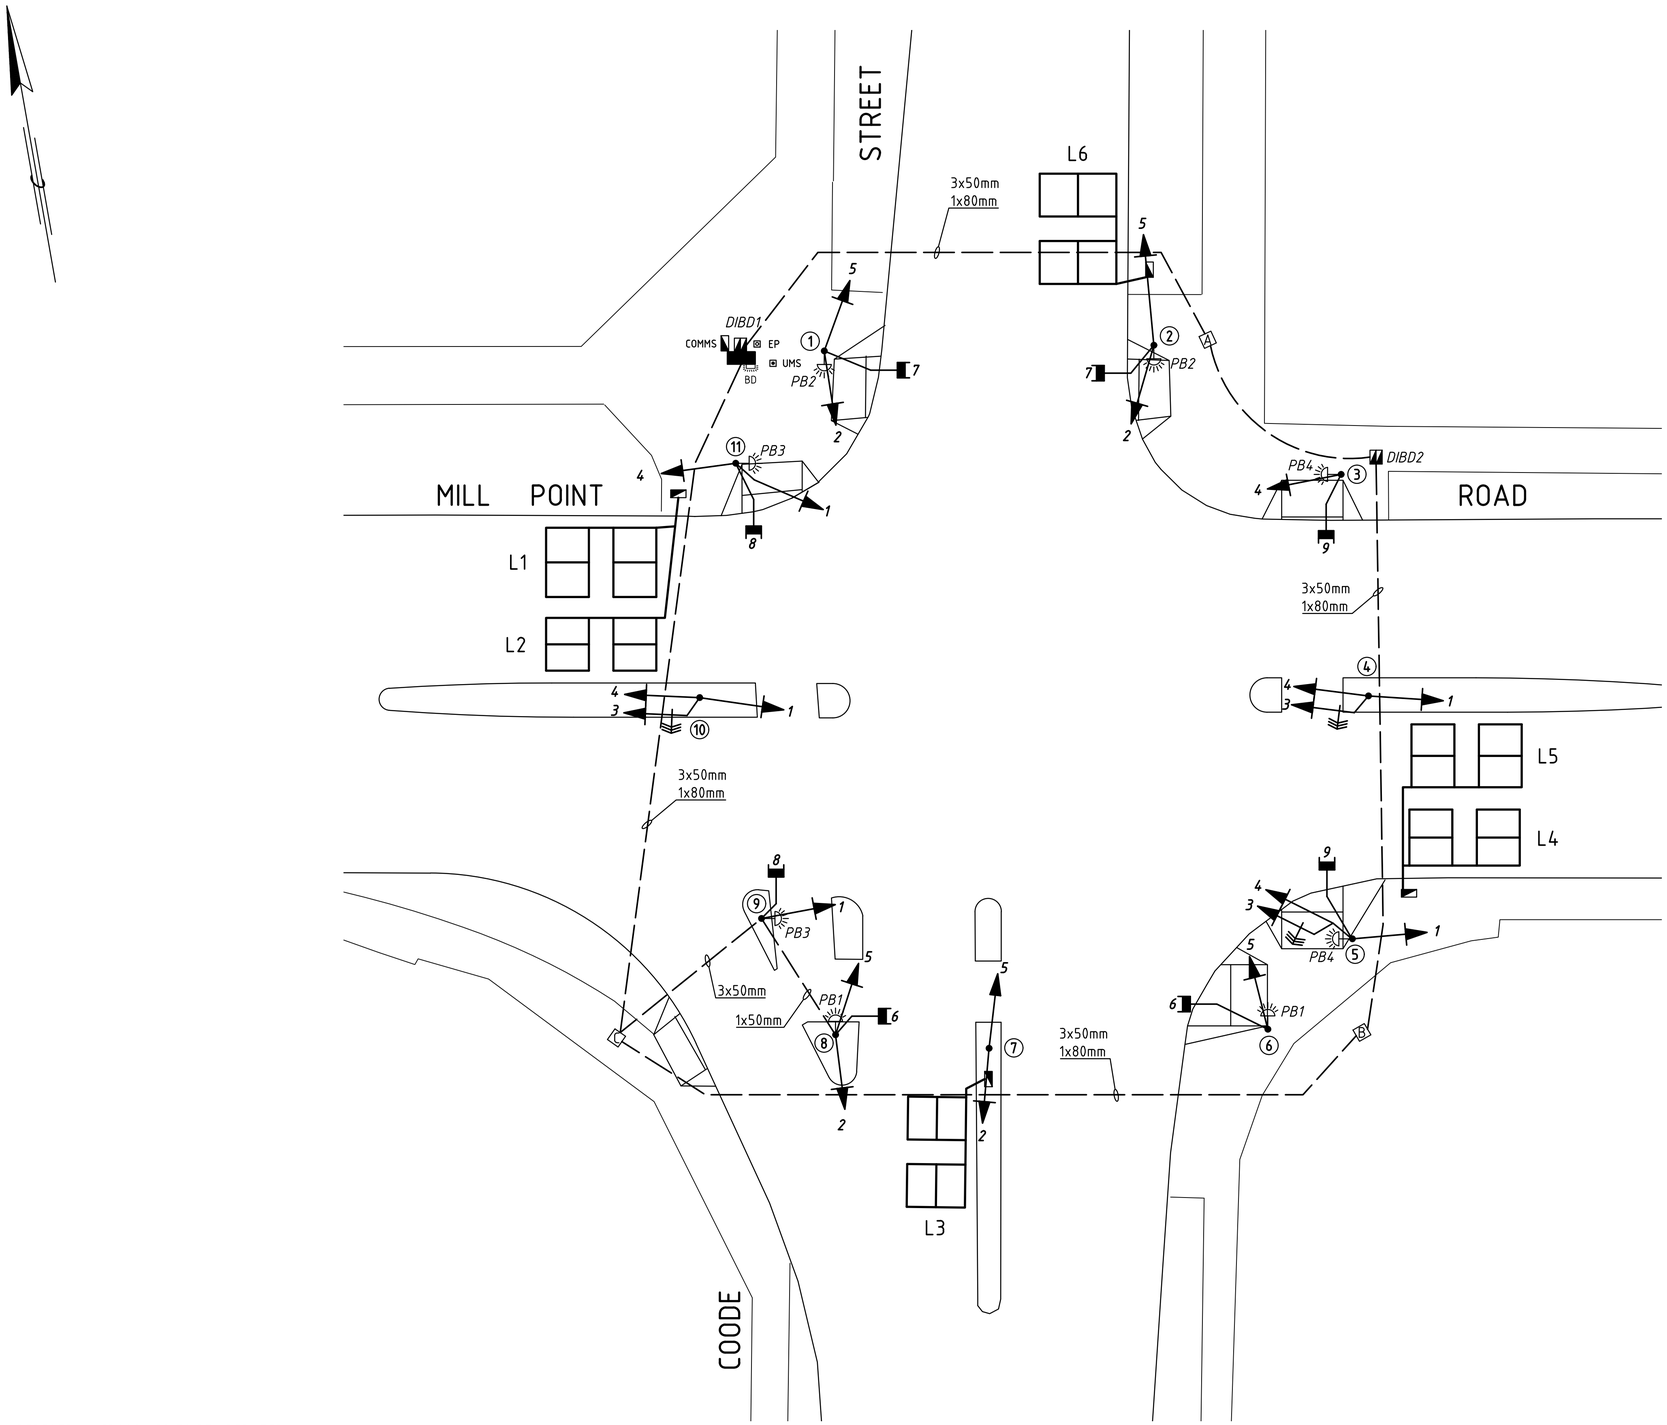

* ALL PEDESTRIAN CROSSINGS TO BE OPERATED AS PARALLEL WALK WITH TIME SEPARATION PROTECTION

TRAFFIC MOVEMENT DIAGRAMS

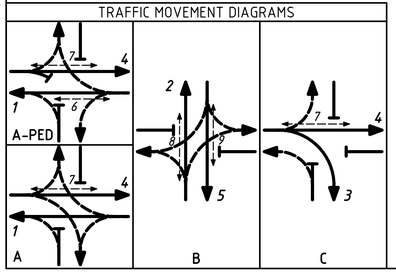

LOOP FEEDER CABLE ROUTE

CONTROLLER *DIBD1* — L1,L2 — C — L3

DIBD2 — L6 — A — L4,L5

UNDERGROUND PIT SYSTEM

PIT	POSTS
■	1,11
A	2,3,4
B	5,6,7
C	8,9,10

PIT TO PIT - 51 CORE
PIT TO POST - 19 CORE

AMENDMENTS

No.	DATE	DESCRIPTION	DRN	ENG	APP
1	12.08.1997	ELV LANTERN UPGRADE			
2	14.09.2001	WALK/DONT WALK LANTERNS ADDED			STC
3	28.06.2004	LRT PHASE & PIT SYSTEM ADDED (JC)			APB
4	10.05.2018	BLUETOOTH DETECTION ADDED TO CABINET			DM
		AS PER SITE MARK UP. COMPLETED BY DM ROADS CCTV TEAM			
5	29.10.2020	CONTROLLER UPGRADED TO ATSC4 WITH ADDINSIGHT BLUETOOTH. SCALE UPDATED	PS		RH

EXISTING SITE LM00389

CONTROLLER	ATSC4
COMMUNICATIONS	TELSTRA DUAL PATH ADSL
BLUETOOTH	YES - ADDINSIGHT

REFERENCES

DRAWING No.	DESCRIPTION
8320-0400	ELECTRICAL PRESENTATION LEGEND
-	TRAFFIC SIGNALS
8420-500	PAVEMENT MARKING & MINOR SIGNING
N/A	CONNECTIVITY & SINGLE LINE DIAGRAM

mainroads WESTERN AUSTRALIA
ELECTRICAL ASSET MANAGEMENT
METROPOLITAN OPERATIONS
WATERLOO CRESCENT EAST PERTH 6892
Telephone: (08) 9323 4111 Fax: (08) 9323 4430

DRAWN: P.SELLERS	DATE: 11.08.2020
ENGINEER:	DATE:
VERIFIED: E.POLLARD	DATE: 28.08.2020
APPROVED: R.HARRIS	DATE: 10.09.2020

SCALE: 1 : 125 A 1

MILL POINT ROAD (0003)
CODE STREET (0014)

AS CONSTRUCTED
TRAFFIC SIGNALS

LOCAL AUTHORITY: (126) CITY OF SOUTH PERTH

MRWA DRG No: 9831-3225	REV: 5	SHEET: 1 of 1
MRWA ASSET No: LM00389	TYPE: A	

COMMISSIONED: 24.08.1982